

NOTE: ALL DRAWINGS ARE CONSIDERED UNCONTROLLED UNLESS STAMPED 'CONTROLLED COPY' IN RED

## AMENDMENTS

| No. | DATE       | DESCRIPTION                                                               | APPROVED   |
|-----|------------|---------------------------------------------------------------------------|------------|
| 8   | 03.2.1995  | SIZE OF CABLE ADDED                                                       | 01.03.1996 |
| 9   | 01.10.1996 | LANTERNS UPGRADED TO ELV,<br>CONTROLLER TO PSC MK2 BOARDS<br>ADDED TARGET | 06.02.1997 |
| 10  | 12.9.2000  | ADDITIONAL L/T ARROW<br>REDRAWN IN CAD                                    |            |
| 11  | 15.11.2003 | CONDUIT DEPTH RESTRICTIONS<br>BETWEEN POLES 7-8                           | APB        |
| 12  | 19.02.2018 | BLUETOOTH DETECTION ADDED TO<br>CABINET                                   | PB         |

## NOTES

## REFERENCES

| DESCRIPTION                            | DRAWING No.           |
|----------------------------------------|-----------------------|
| LEGEND (TRAFFIC SIGNALS)               | 8320-04.00            |
| CONDUITS (STANDARD)                    | 8420-0700             |
| RAISED PAVEMENT MARKERS                | 9120-0158 & 9120-0159 |
| PEDESTRIAN RAMP DETAILS                | 9331-380              |
| KERBING TYPE                           | 9331-0376             |
| TRAFFIC SIGNAL POLE AND LOOP LAYOUT    | -                     |
| MINOR SIGNING AND<br>PAVEMENT MARKINGS | 9431-3126             |



### METROPOLITAN REGION

WATERLOO CRESCENT EAST PERTH 6004  
Telephone (08) 9323 4111 Fax (08) 9323 4684

| SURVEYED    | DATE                   |
|-------------|------------------------|
| DRAWN       | C. IDDON 08.01.2018    |
| CHECKED     | P. BARUA 09.01.2018    |
| AUTHORISED  | N. MARSHALL 19.02.2018 |
| RECOMMENDED |                        |

SUTHERLAND STREET (0061)  
RAILWAY STREET (0060)

AS CONSTRUCTED  
TRAFFIC SIGNALS

LOCAL AUTHORITY (124) CITY OF PERTH

COMMISSIONED

07.12.1953


DRAWING NUMBER

9431-3125 - 12

REV.

12

LM00001

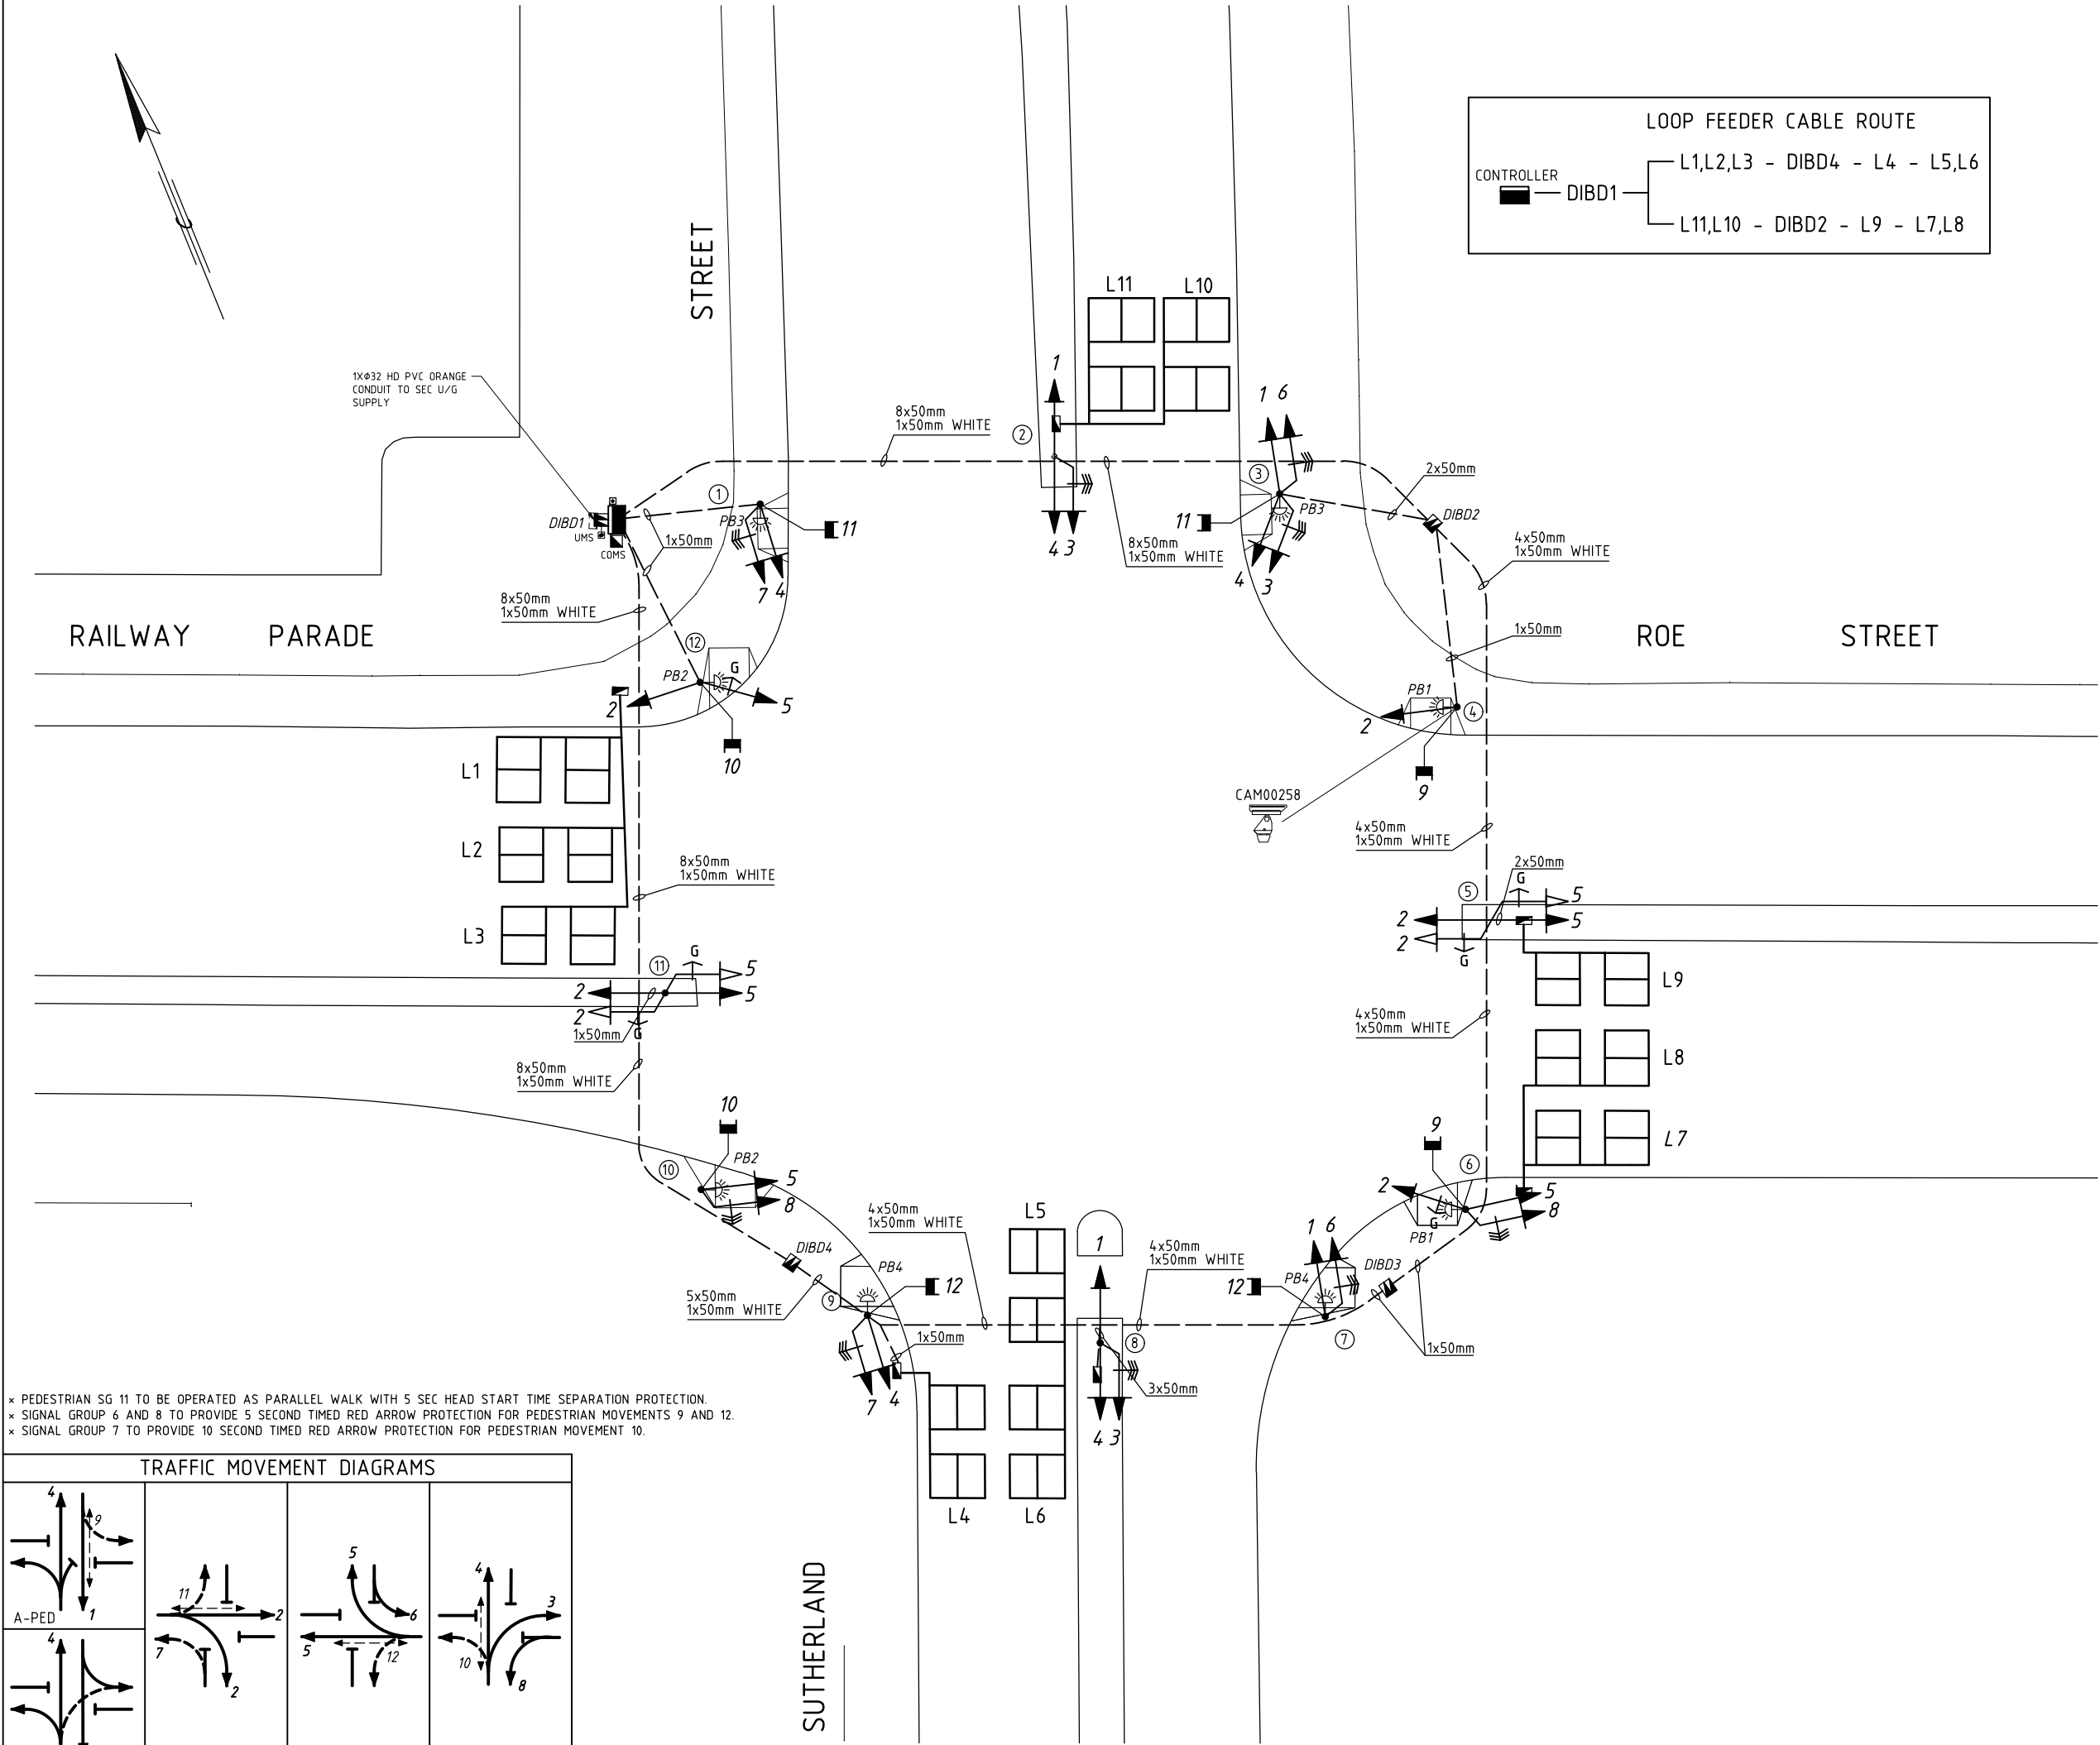

- \* PEDESTRIAN SG 11 TO BE OPERATED AS PARALLEL WALK WITH 5 SEC HEAD START TIME SEPARATION PROTECTION.
- \* SIGNAL GROUP 6 AND 8 TO PROVIDE 5 SECOND TIMED RED ARROW PROTECTION FOR PEDESTRIAN MOVEMENTS 9 AND 12.
- \* SIGNAL GROUP 7 TO PROVIDE 10 SECOND TIMED RED ARROW PROTECTION FOR PEDESTRIAN MOVEMENT 10.

### TRAFFIC MOVEMENT DIAGRAMS

