


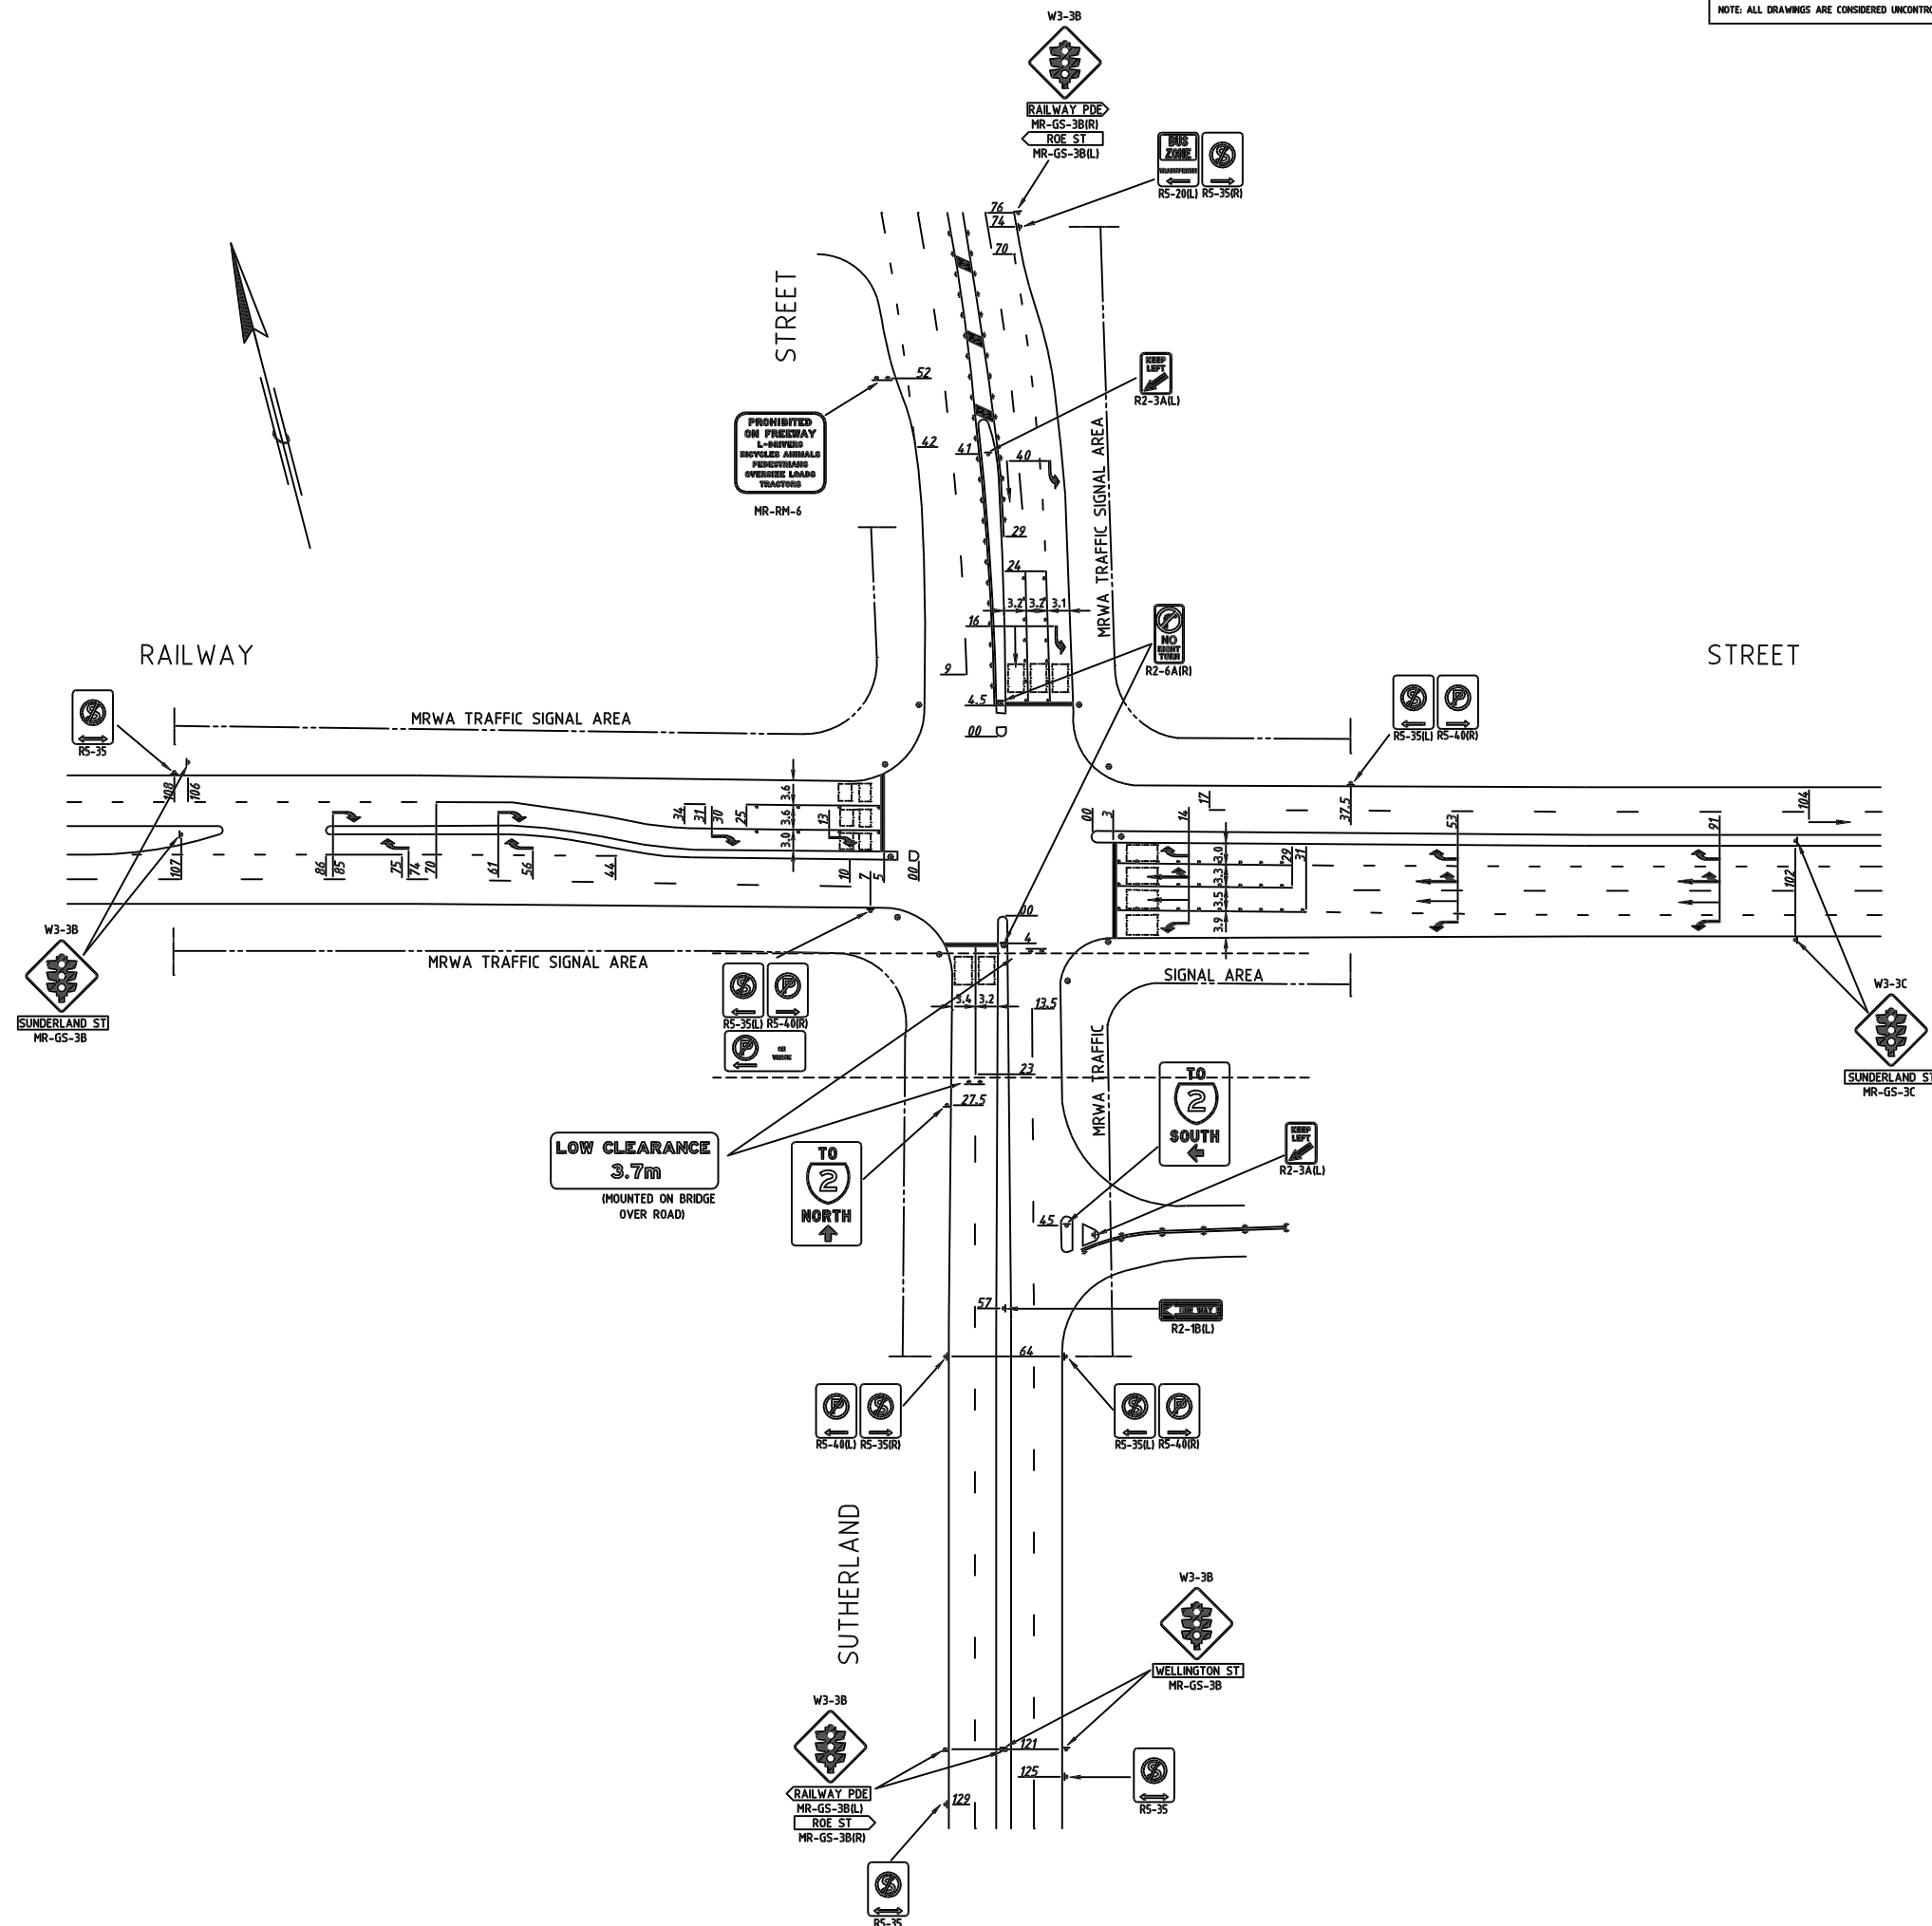

NOTE: ALL DRAWINGS ARE CONSIDERED UNCONTROLLED UNLESS STAMPED 'CONTROLLED COPY' IN RED

AMENDMENTS

	DATE	DESCRIPTION	APPROVED
1	18.6.80	PPB'S ADDED	
2	10.8.84	ELECTRICALLY UPGRADED	
3	17.8.87	RAILWAY ST WIDENED	
4		SUTHERLAND ST ALTERED	16.12
5		TARGET BOARDS SHOWN	
6		TARGET BOARDS ADDED 10	4.11
7	1.10.96	LANTERNS UPGRADED TO ELV CONTROLLER TO PSC MK2 TARGET BOARDS ADDED	2.3
8	14.12.98	KEEP LEFT & RRPMS TO MARKET ST	14.12
9	12.9.00	DRAWN IN CAD	

NOTES

REFERENCES

DESCRIPTION	DRAWING No.
METROPOLITAN STREET DIRECTORY No.	60-D10
LEGEND (TRAFFIC SIGNALS)	8320-0400
LEGEND (SYMBOLS)	8525-0316 & 8525-0317
CONDUITS (STANDARD)	8420-0700
RAISED PAVEMENT MARKERS	9120-0158 & 9120-0159
PEDESTRIAN RAMP DETAILS	9831-5649
KERBING TYPE	9331-376
CHANNELISATION	-
TRAFFIC SIGNAL POLE AND LOOP LAYOUT	9431-3125
MINOR SIGNING AND PAVEMENT MARKINGS	-
PROFILES	-
CROSS SECTIONS	-
GUIDE SIGNS LAYOUT	-
SURVEY MODEL NAME	-
DESIGN MODEL NAME	WEST PERTH SUBWAY PLAN

CLIENT



MAIN ROADS

Western Australia

METROPOLITAN OPERATIONS

2 Adams Drive
Telephone (08) 9311 8333

Welshpool W.A. 6196
Fax (08) 9311 8383

SURVEYED	MRWA	DATE 2.12.87
DRAWN	MRWA	2.12.87
CHECKED	T. HAZE BROEK	4.12.87
AUTHORISED	I. EDWARDS	2.3.88
RECOMMENDED	I. EDWARDS & S. CHITTY	17.3.88

RAILWAY STREET (117)
SUTHERLAND (38)

AS CONSTRUCTED
PAVEMENT MARKINGS AND MINOR SIGNING

LOCAL AUTHORITY (124) CITY OF PERTH

COMMISSIONED

7.12.53

DRAWING NUMBER	AMEND.
9431-3126-9	

LM001^B

3